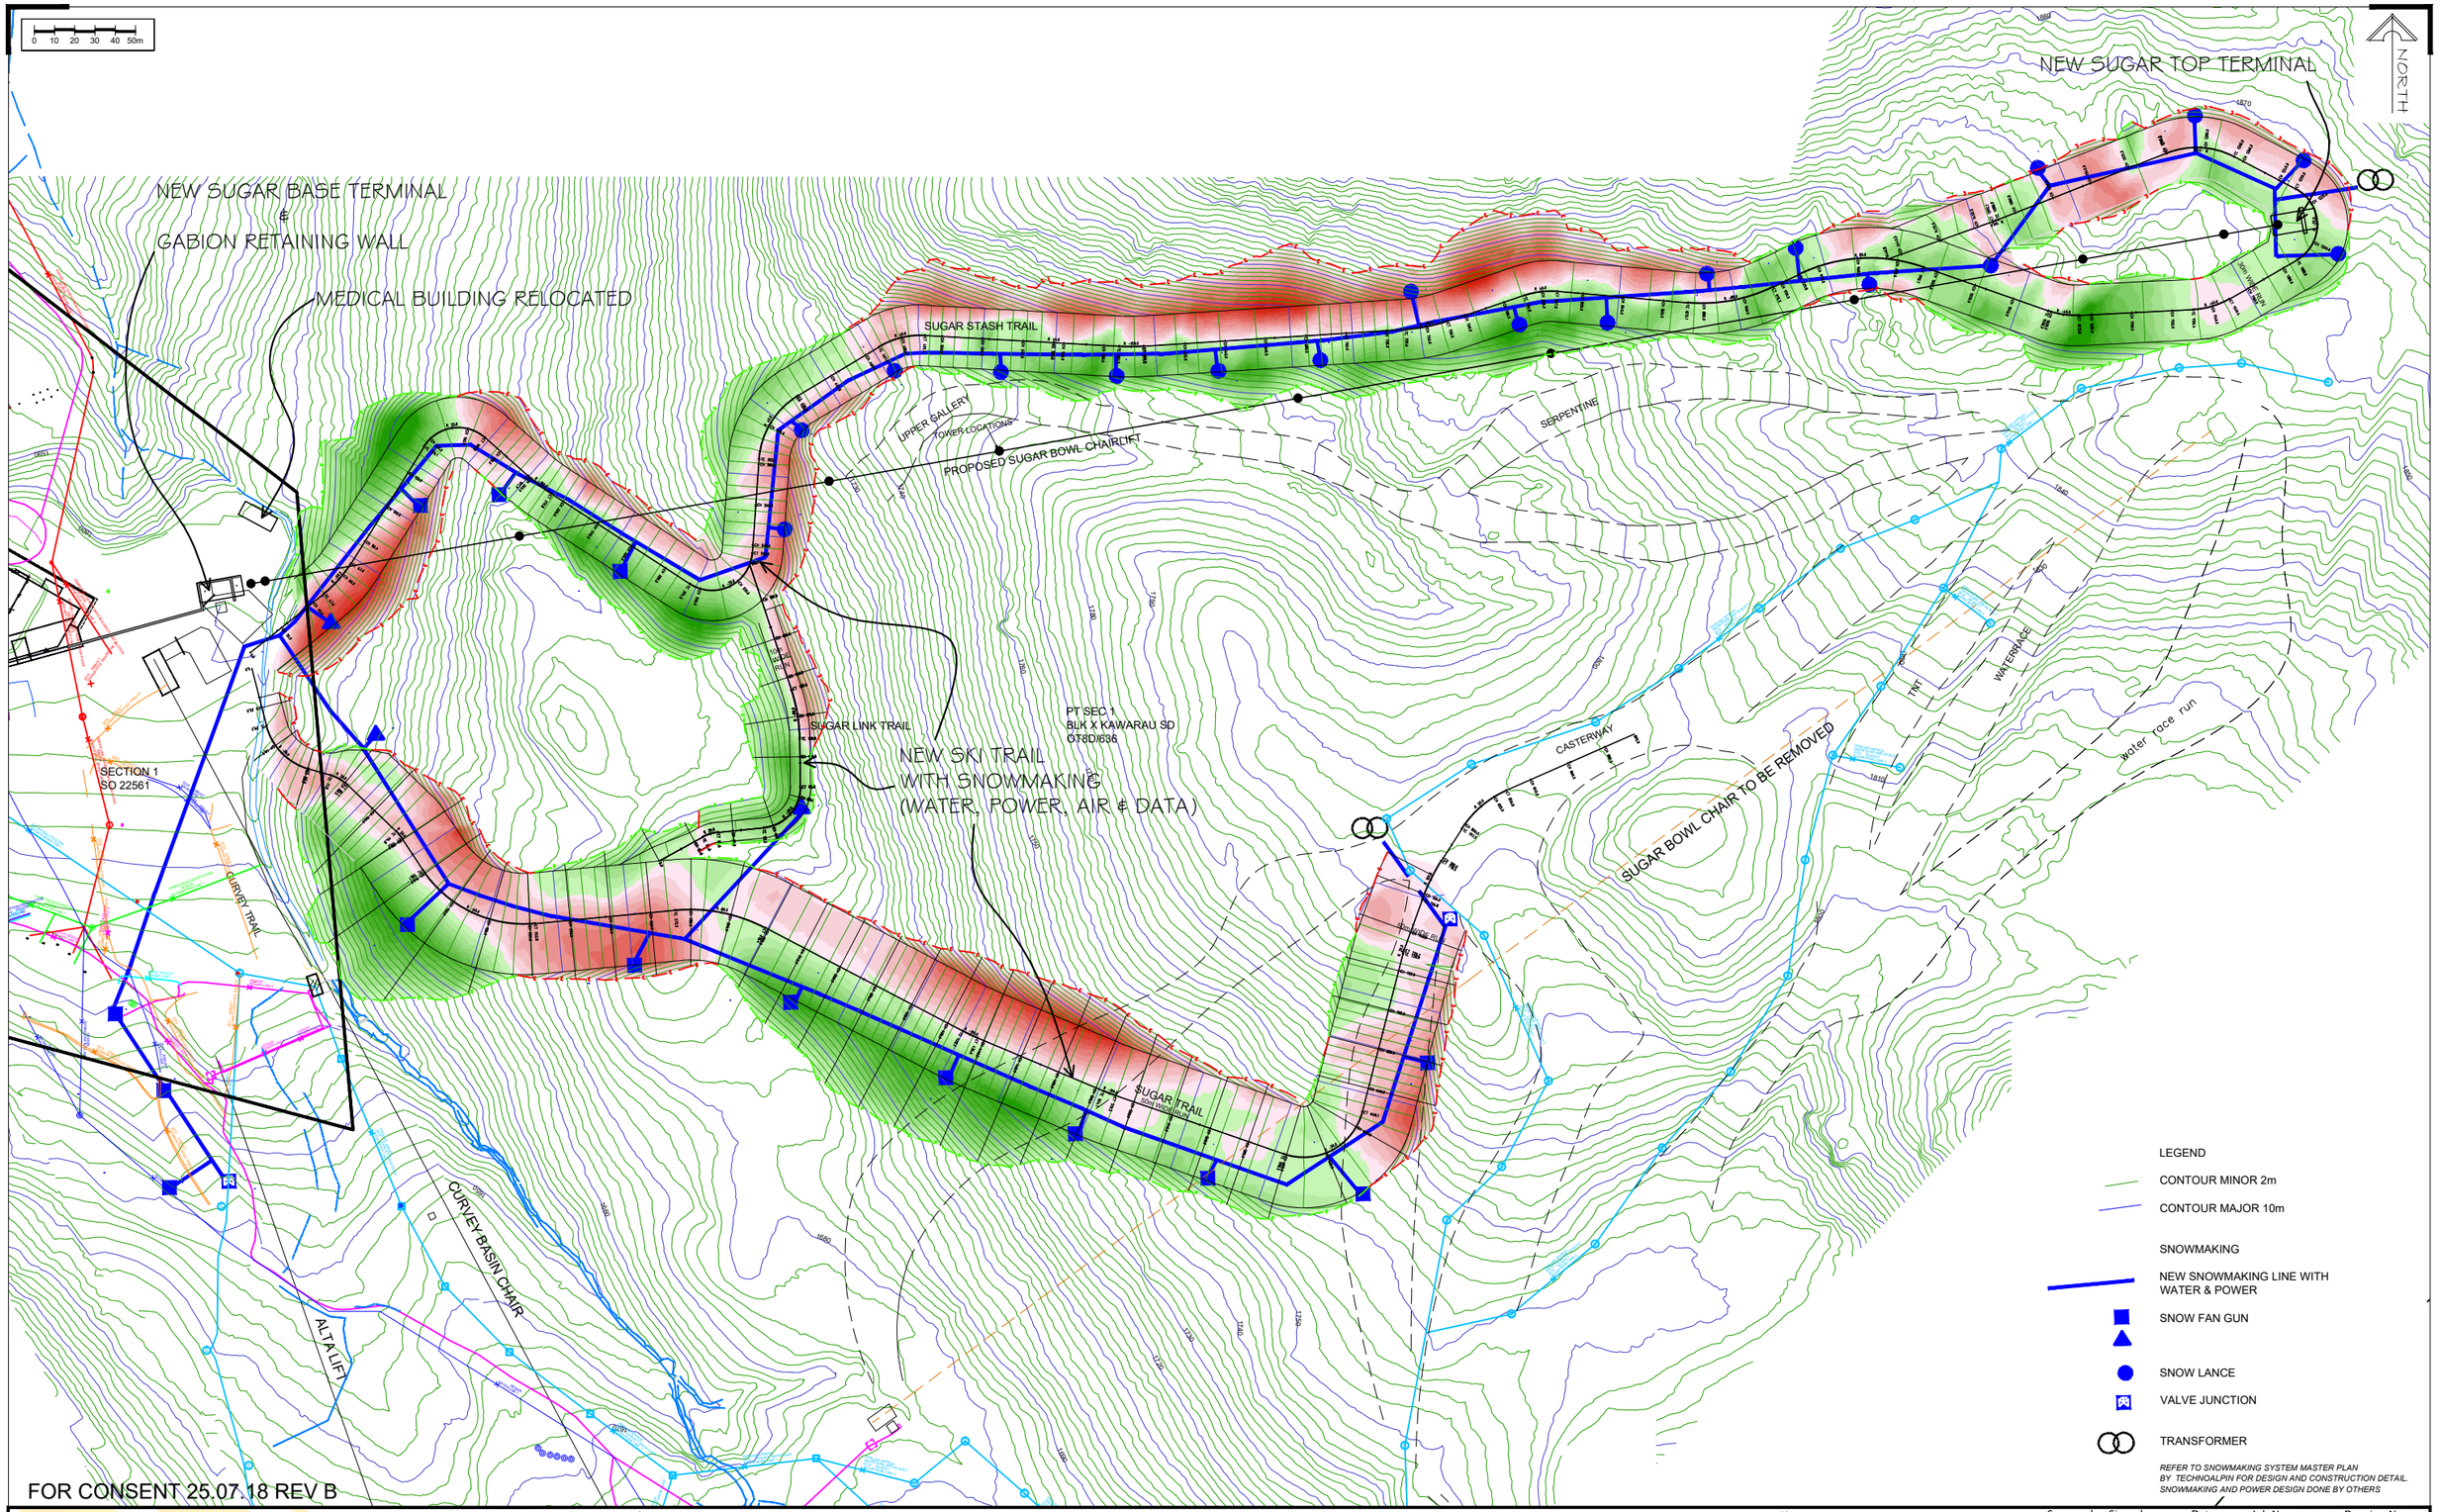

FOR CONSENT 25.07.18 REV B

Shotover Design Limited trading as
Clark Fortune McDonald & Associates
Licensed Cadastral Surveyors - Land Development - Planning Consultants
309 Lower Shotover Road, P.O.Box 553 Queenstown
Tel. (03)441-6044, Fax (03)442-1066, Email admin@cfma.co.nz
Shop 2, Otago House, 475 Moray Place, P.O. Box 5960
Tel. (03)470-1582, Fax (03)470-1583, Email admin@cfma.co.nz

Rev.	Date	Revision Details	By
A	19.09.18	REVISED SUGAR, SUGAR STASH TRAIL @ BTM	EM
B	3.10.18	SNOWMAKING LINES ADDED	EM

REMARKABLES SKI FIELD
OVERALL LAYOUT & VOLUME PLAN WITH ASBUILT & SNOWMAKING OVERLAY

Client: NZ SKI LTD

Notes: Snowmaking design provided by others and best fitted to Trails. Location to be confirmed

- All dimensions shown are in meters unless shown otherwise.
- Any person using Clark Fortune McDonald drawings and other data accepts the risk of:
  - Using the drawings and other data in electronic form without requesting and checking them for accuracy against the original hard copy versions.
  - Ensuring the information is the most recent issue.
- Copyright on this drawing is reserved.

	Surveyed	Signed	Date	Job No.	Drawing No.
			x.x.18	12650	18-11
Drawn	Signed	Date	Scale		
EM		11.06.18	1:1500 @ A1 1:3000 @ A3		
Designed	Signed	Date	Datum & Level		Rev.
CFM w NZSKI		2018	NZMG & MSL		B

S:\JOBS\12600\12650\acad\12650 18 Design Plans Sugar Bowl II 25.07.18 REV B.dwg Plotted: 08.10.2018